

401 KESHWOODS ST. NE
WASHINGTON, DC 20017

PARKER RODRIGUEZ INC.
100 North Street, S.E.
Washington, DC 20003
Phone: 202-391-7600
Fax: 202-391-7600

OWNER
CDC
323 Connecticut Avenue, NW
Suite 200
Washington, DC 20001
202-691-8930

ARCHITECT
Woodward Clyde
1100 L Street, N.E.
Washington, DC 20002
202-547-8100

CONSULTANT
WMA Consultants
17800 Linton Road, S.E.
Suite 200
Falls Church, VA 22041
703-991-7600

DESIGNER
WMA Consultants
17800 Linton Road, S.E.
Suite 200
Falls Church, VA 22041
703-991-7600

DATE
July 2020


SCALE
AS SHOWN

DATE
July 2020


SCALE
AS SHOWN

DATE
July 2020


SCALE
AS SHOWN

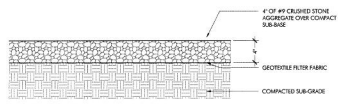


01 GRAVEL ON GRADE
SCALE: 1:100 (1\"/>

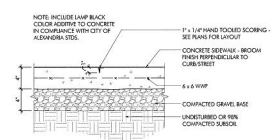


02 CONCRETE PAVING ON GRADE - PEDESTRIAN
SCALE: 1:100 (1\"/>

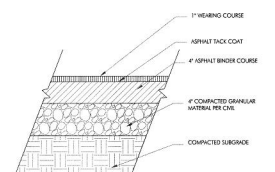


03 ASPHALT PAVING ON GRADE - VEHICULAR
SCALE: 1:100 (1\"/>

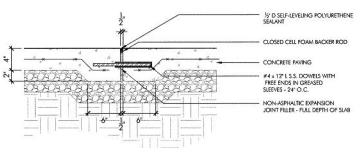

04 EXPANSION JOINT
SCALE: 1:100 (1\"/>

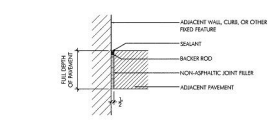


05 ISOLATION JOINT
SCALE: 1:100 (1\"/>

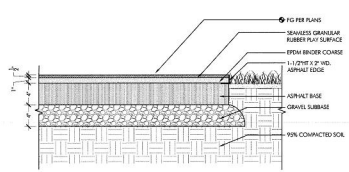


06 RUBBERIZED SURFACE ON GRADE - PEDESTRIAN
SCALE: 1:100 (1\"/>


- NOTES:
1. RUBBER MIXTURE DESIGNED FOR 3 FT FALL HEIGHT
 2. RUBBER PLAY SURFACE TO BE SEAMLESS EUROFER BY DORC, COLOR TR0
 3. BACKERS 1/2\"/>

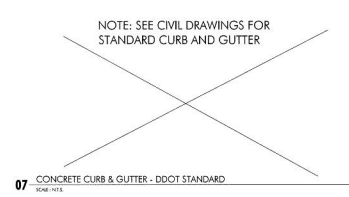

07 CONCRETE CURB & GUTTER - DDOT STANDARD
SCALE: N/A

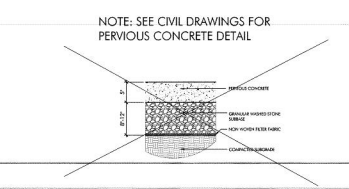

08 PERVIOUS CONCRETE
SCALE: 1:100 (1\"/>

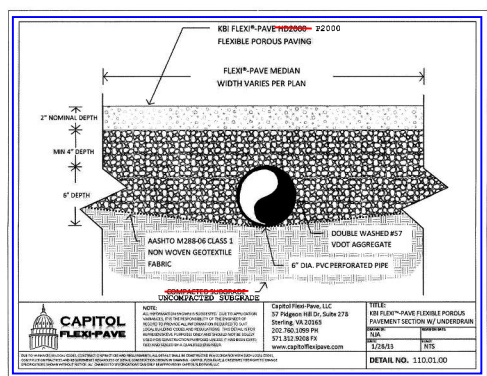

09 FALL ZONE SURFACE AT WATER FEATURE PERIMETER
SCALE: N/A

	<p>NOTE: All work shall be in accordance with the latest edition of the DC Department of Transportation (DDOT) Standard Specifications for Road and Bridge Construction, Section 200.01, and the DC Department of Transportation (DDOT) Standard Specifications for Waterways and Marine Structures, Section 200.01.</p>	<p>Capitol Flexi-Pave, LLC 27 Piquette Mill Dr., Suite 2718 Stafford, VA 20185 202-766-2099 PH 571-332-8008 FX www.capitolflexipave.com</p>	<p>TITLE FLEXI-PAVE FLEXIBLE POROUS PAVEMENT SECTION W/ UNDERDRAIN</p>
	<p>DATE 07/21/21</p>	<p>DATE 07/21/21</p>	<p>DETAIL NO. 110.01.00</p>

REVISION	
02-04-20	05-08-11
03-02-20	07-26-11

HARDSCAPE DETAILS

ORIGINAL DATE
05-08-11

DATE OF REVISION
DC, DP

CONTRACT NO.
07-1P

CHECKED BY
DC

NORTH

SCALE
THAMES PROJECT

DATE
07/21/21