

LAYOUT AND MATERIALS LEGEND

	DETAIL NUMBER		LIMITS OF WORK		VEHICULAR CONCRETE PAVEMENT
	MESH RAILING		MESH RAILING WITH ATTACHED HANDRAIL		FLEXIBLE PERMEABLE PAVEMENT
	METAL HANDRAIL		PICNIC TABLE		COLOR 1 COURT SURFACING
	PARK BENCH		COLOR 2 COURT SURFACING		COLOR 3 COURT SURFACING
	TRASH/RECYCLING RECEPTACLE		RETAINING WALL WITH EMBEDDED METAL RAILING		SEAT WALL
	TREE WELL		RETAINING WALL WITH EMBEDDED METAL RAILING		RETAINING WALL WITH EMBEDDED METAL RAILING


ARLINGTON COUNTY, VIRGINIA
DEPARTMENT OF ENVIRONMENTAL SERVICES

SITE LAYOUT AND MATERIALS PLAN

SCALE:	DESIGNED:	CHECKED:	COVER:
SUBMITTED DATE:	APPROVED DATE:	APPROVED DATE:	APPROVED DATE:
CHIEF WATER, SEWER, & STR. BUREAU	CHIEF ENGINEERING BUREAU	DIRECTOR OF ENV. SERVICES	
SHEET		CONTRACT H- SHEET OF	

LAYOUT AND MATERIAL NOTES

- THE EXISTING AND PROPOSED UNDERGROUND UTILITIES SHOWN HEREON ARE BASED UPON AVAILABLE INFORMATION. THE CONTRACTOR SHALL BE RESPONSIBLE FOR CALLING MISS UTILITY TO DETERMINE THE EXACT LOCATION OF ALL UTILITIES BEFORE COMMENCING WORK AND IS RESPONSIBLE FOR ANY DAMAGES WHICH OCCUR BY HIS FAILURE TO LOCATE OR PRESERVE THESE UNDERGROUND UTILITIES.
- IT SHALL BE THE RESPONSIBILITY OF THE CONTRACTOR TO OBTAIN ALL NECESSARY PERMITS AND COORDINATE WITH POWER COMPANY FOR ALL ELECTRICAL WORK INCLUDING SPORTS LIGHTING AND PROJECT MOBILIZATION.
- ANY DAMAGE TO THE EXISTING CONDITIONS TO REMAIN DUE TO CONSTRUCTION OPERATIONS SHALL BE THE RESPONSIBILITY OF THE CONTRACTOR. THE FENCE SHALL BE REPAIRED IF SUCH DAMAGES OCCUR AT THE EXPENSE OF THE CONTRACTOR BEFORE FINAL ACCEPTANCE AND PAYMENT.
- COURT SURFACING LINE LAYOUT, DIMENSIONS SHOWN FOR BASKETBALL ARE TAKEN FROM INSIDE EDGE OF COURT BOUNDARY LINE. DIMENSIONS SHOWN FOR VOLLEYBALL ARE TAKEN FROM OUTSIDE EDGE OF COURT BOUNDARY LINE. DIMENSIONS SHOWN FOR FUTSAL ARE TAKEN FROM OUTSIDE EDGE OF COURT BOUNDARY LINE. ALL INTERIOR LINES SHALL BE TAKEN FROM CENTERLINE OF LINE.
- DUE TO THE COMPLEX NATURE OF THE DESIGN, ALL HARDSCAPE INCLUDING WALLS, SEATWALLS, STAIRS, PAVEMENT, BOARDWALK ETC. SHALL BE SURVEY LOCATED AT APPROPRIATE INCREMENTS TO ACHIEVE PROPER INSTALLATION. RAILINGS AND HANDRAILS SHALL BE INSTALLED AFTER INSTALLATION OF HARDSCAPE. LAYOUT SHALL BE APPROVED BY COUNTY LANDSCAPE ARCHITECT PRIOR TO COMMENCEMENT OF CONSTRUCTION.
- CONCRETE SCORING SHALL BE APPLIED AS SHOWN ON THIS PLAN.
- RIGHT-OF-WAY TO BE VACATED BY ARLINGTON COUNTY REAL ESTATE BUREAU (KEVIN CONNOLLY).
- THE EXISTING SHELTER WILL BE DECONSTRUCTED, STORED, AND RECONSTRUCTED AS SHOWN ON THE PLANS. THE ROOFING AND FASTENERS SHALL BE REPLACED WITH NEW MATERIAL-REFER TO SPECS. CONTRACTOR TO SUBMIT A RECONSTRUCTION PLAN OF THE SHELTER.

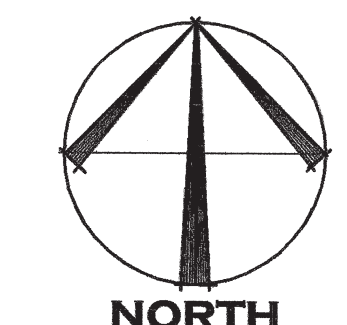

DEPARTMENT OF PARKS AND RECREATION


Planning and Design Unit
2100 Clarendon Boulevard, Suite 414
Arlington, VA 22201
Phone: 703.228.3337
Fax: 703.228.3328

Project Name and Location Rocky Run Park Renovation

1109 North Barton Street
Arlington, VA 22201

Sheet Title

Site Layout and Materials Plan

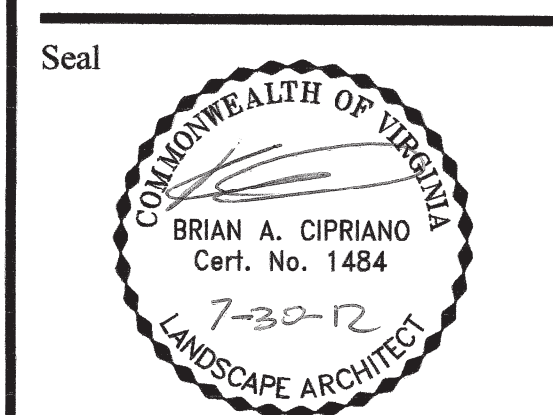

Approvals	Date
DEPARTMENT DIRECTOR	7/31/12
PLANNING AND DESIGN DIVISION CHIEF	7/31/12
DESIGN TEAM SUPERVISOR	7/31/12
PARK SERVICE AREA MANAGER	7/31/12
URBAN FORESTRY	7/31/12

Revisions	Date

ITB # 508-13
SWM # 12-1214

Designed: B. Cipriano
Drawn: B. Cipriano
Checked: B. Cipriano
Filename: 0701-LM.dwg
Path: G:\project\planning\2789\0701\PLANS
Plotted: Jul 27, 2012
Scale: 1" = 20'
Date: July 2012
Sheet