

ALIGNMENT

BASELINE

CONCRETE

EQUAL


BL CONC

CPM EQ

РΑ

LAYOUT LEGEND



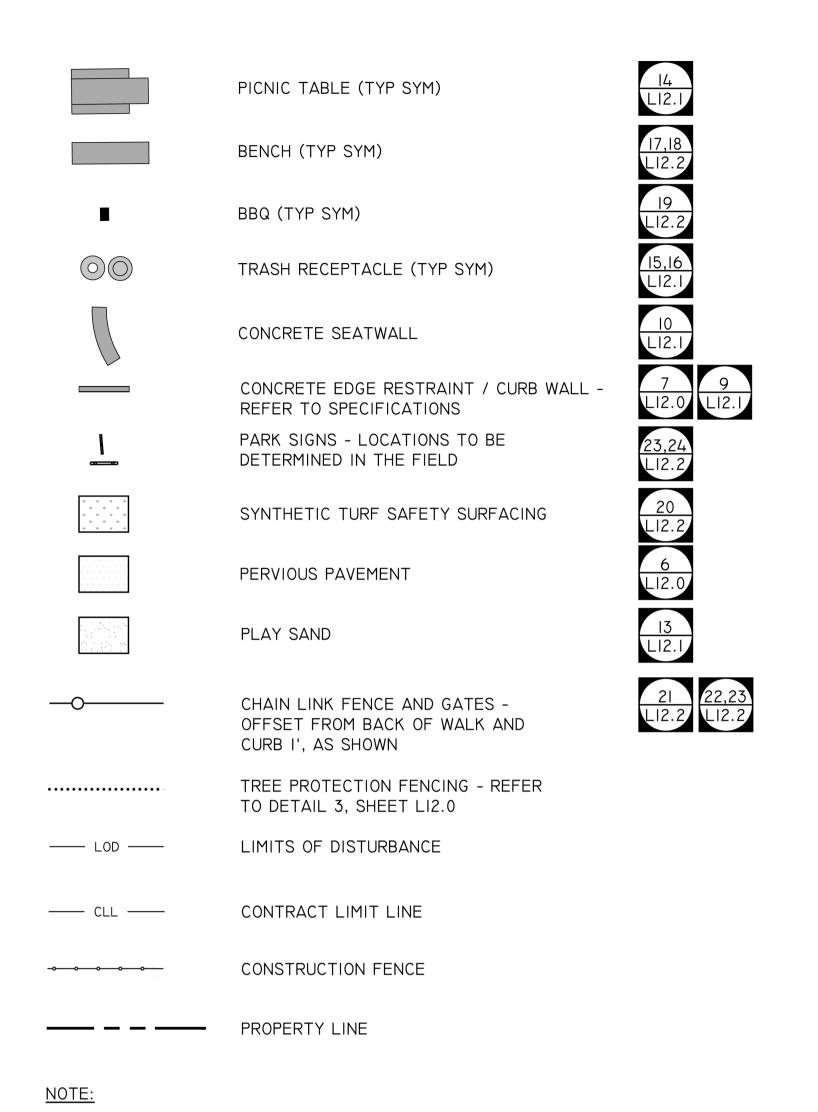

LAYOUT NOTES

- THE POINT OF BEGINNING (POB) SHALL BE THE CENTERPOINT OF MANHOLES #4 AND #13, AS SHOWN
- 2. FOR THE PURPOSES OF THIS LAYOUT, BOTH BASELINE "A" AND "B" SHALL BE PERPENDICULAR TO BASELINE "C", AS SHOWN.
- 3. NEW WORK SHALL MEET AND MATCH EXISTING ALIGNMENT OF FEATURES AND FINISHED GRADES AT EXISTING PAVEMENT OR OTHER FACILITIES TO REMAIN. THE CONTRACTOR SHALL MAKE ANY NECESSARY MINOR ADJUSTMENTS IN THE PROPOSED WORK TO MEET THE INTENT OF THE PLANS AND TO PROVIDE SMOOTH TRANSITIONS BETWEEN EXISTING CONDITIONS AND NEW WORK.
- 4. THE CONTRACTOR SHALL CHECK AND VERIFY ALL DIMENSIONS, SPOT ELEVATIONS AND EXISTING CONDITIONS IN THE FIELD AND SHALL BE RESPONSIBLE FOR PERFORMING THE WORK IN ACCORDANCE WITH THE SAME. CONTRACTOR SHALL NOTIFY PROJECT OFFICER OF ANY DISCREPANCIES, PRIOR TO COMMENCING WITH WORK.
- 5. THE CONTRACTOR SHALL STAKE THE ALIGNMENT OF PAVEMENT, EDGING, WALKS, AND SITE FEATURES IN THE FIELD FOR APPROVAL BY THE PROJECT OFFICER PRIOR TO INSTALLATION. NO CHANGES SHALL BE MADE TO THE DESIGN OR LAYOUT OF THE PROJECT WITHOUT WRITTEN APPROVAL BY THE PROJECT OFFICER PRIOR TO INSTALLATION.
- 6. LAYOUT OF PARK BENCHES, PICNIC TABLE, LANDSCAPE BOULDERS, TRASH RECEPTACLES, SIGNS, AND BIKE RACKS IS APPROXIMATE. LAYOUT SHALL BE DETERMINED AND VERIFIED BY PROJECT OFFICER IN THE FIELD. PLACEMENT OF ALL SITE FURNISHINGS MUST MEET CURRENT ADA REQUIREMENTS.
- 7. REFER TO SHEET L9.0 FOR PLAY AREA EQUIPMENT LAYOUT.

REFER TO SHEET L9.0 FOR PLAY EQUIPMENT INFORMATION



DEPARTMENT OF PARKS RECREATION

Park Development Division 2100 Clarendon Boulevard, Suite 414 Arlington, VA 22201 Phone: 703.228.3323 Fax: 703.228.3328

IFB #617-12

Project Name and Location

Ft Myer Heights Playground Reconstruction

1400 N. Fort Myer Drive Arlington, VA

Sheet Title

Layout Plan

Approvals	Da
Divesh	2/27
Department Director	
X Delle	2/21/
Park Development Divis	ion Chief
17-8XMW	- 2/21/1
Design Unit Supervisor	, ,

Date

Designed: AW Drawn: AW Checked: BG

Revisions

Filename: Layout.dwg Plotted: May 09, 2012

Scale: AS_SHOWN Date: DATE

Seal

Sheet 4 of 14