


**LONG BRIDGE AQUATIC HEALTH
AND FITNESS FACILITY**

PROJECT LOCATION: ARLINGTON, VIRGINIA
OWNER: ARLINGTON COUNTY DEPARTMENT OF PARKS AND RECREATION
ADDRESS: 333 LONG BRIDGE PARK DRIVE
ARLINGTON, VA 22202

PROJECT / OWNER



SEAL

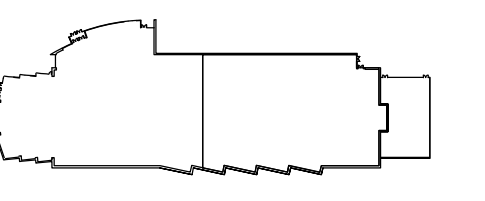

KEY PLAN

04.02.2013 ISSUE FOR PERMIT
07.22.2013 PERMIT RESUBMISSION
08.22.2013 ISSUE FOR BID

MARK DATE ISSUE


DRAWN BY: WH, BAJ
CHECKED BY: MG, BAJ
PROJECT NO: 0913; LSG 25023.03

Copyright © 2013
by LSG Landscape Architecture

**PLANTING
PLAN**

SCALE: 1" = 30'

L-501

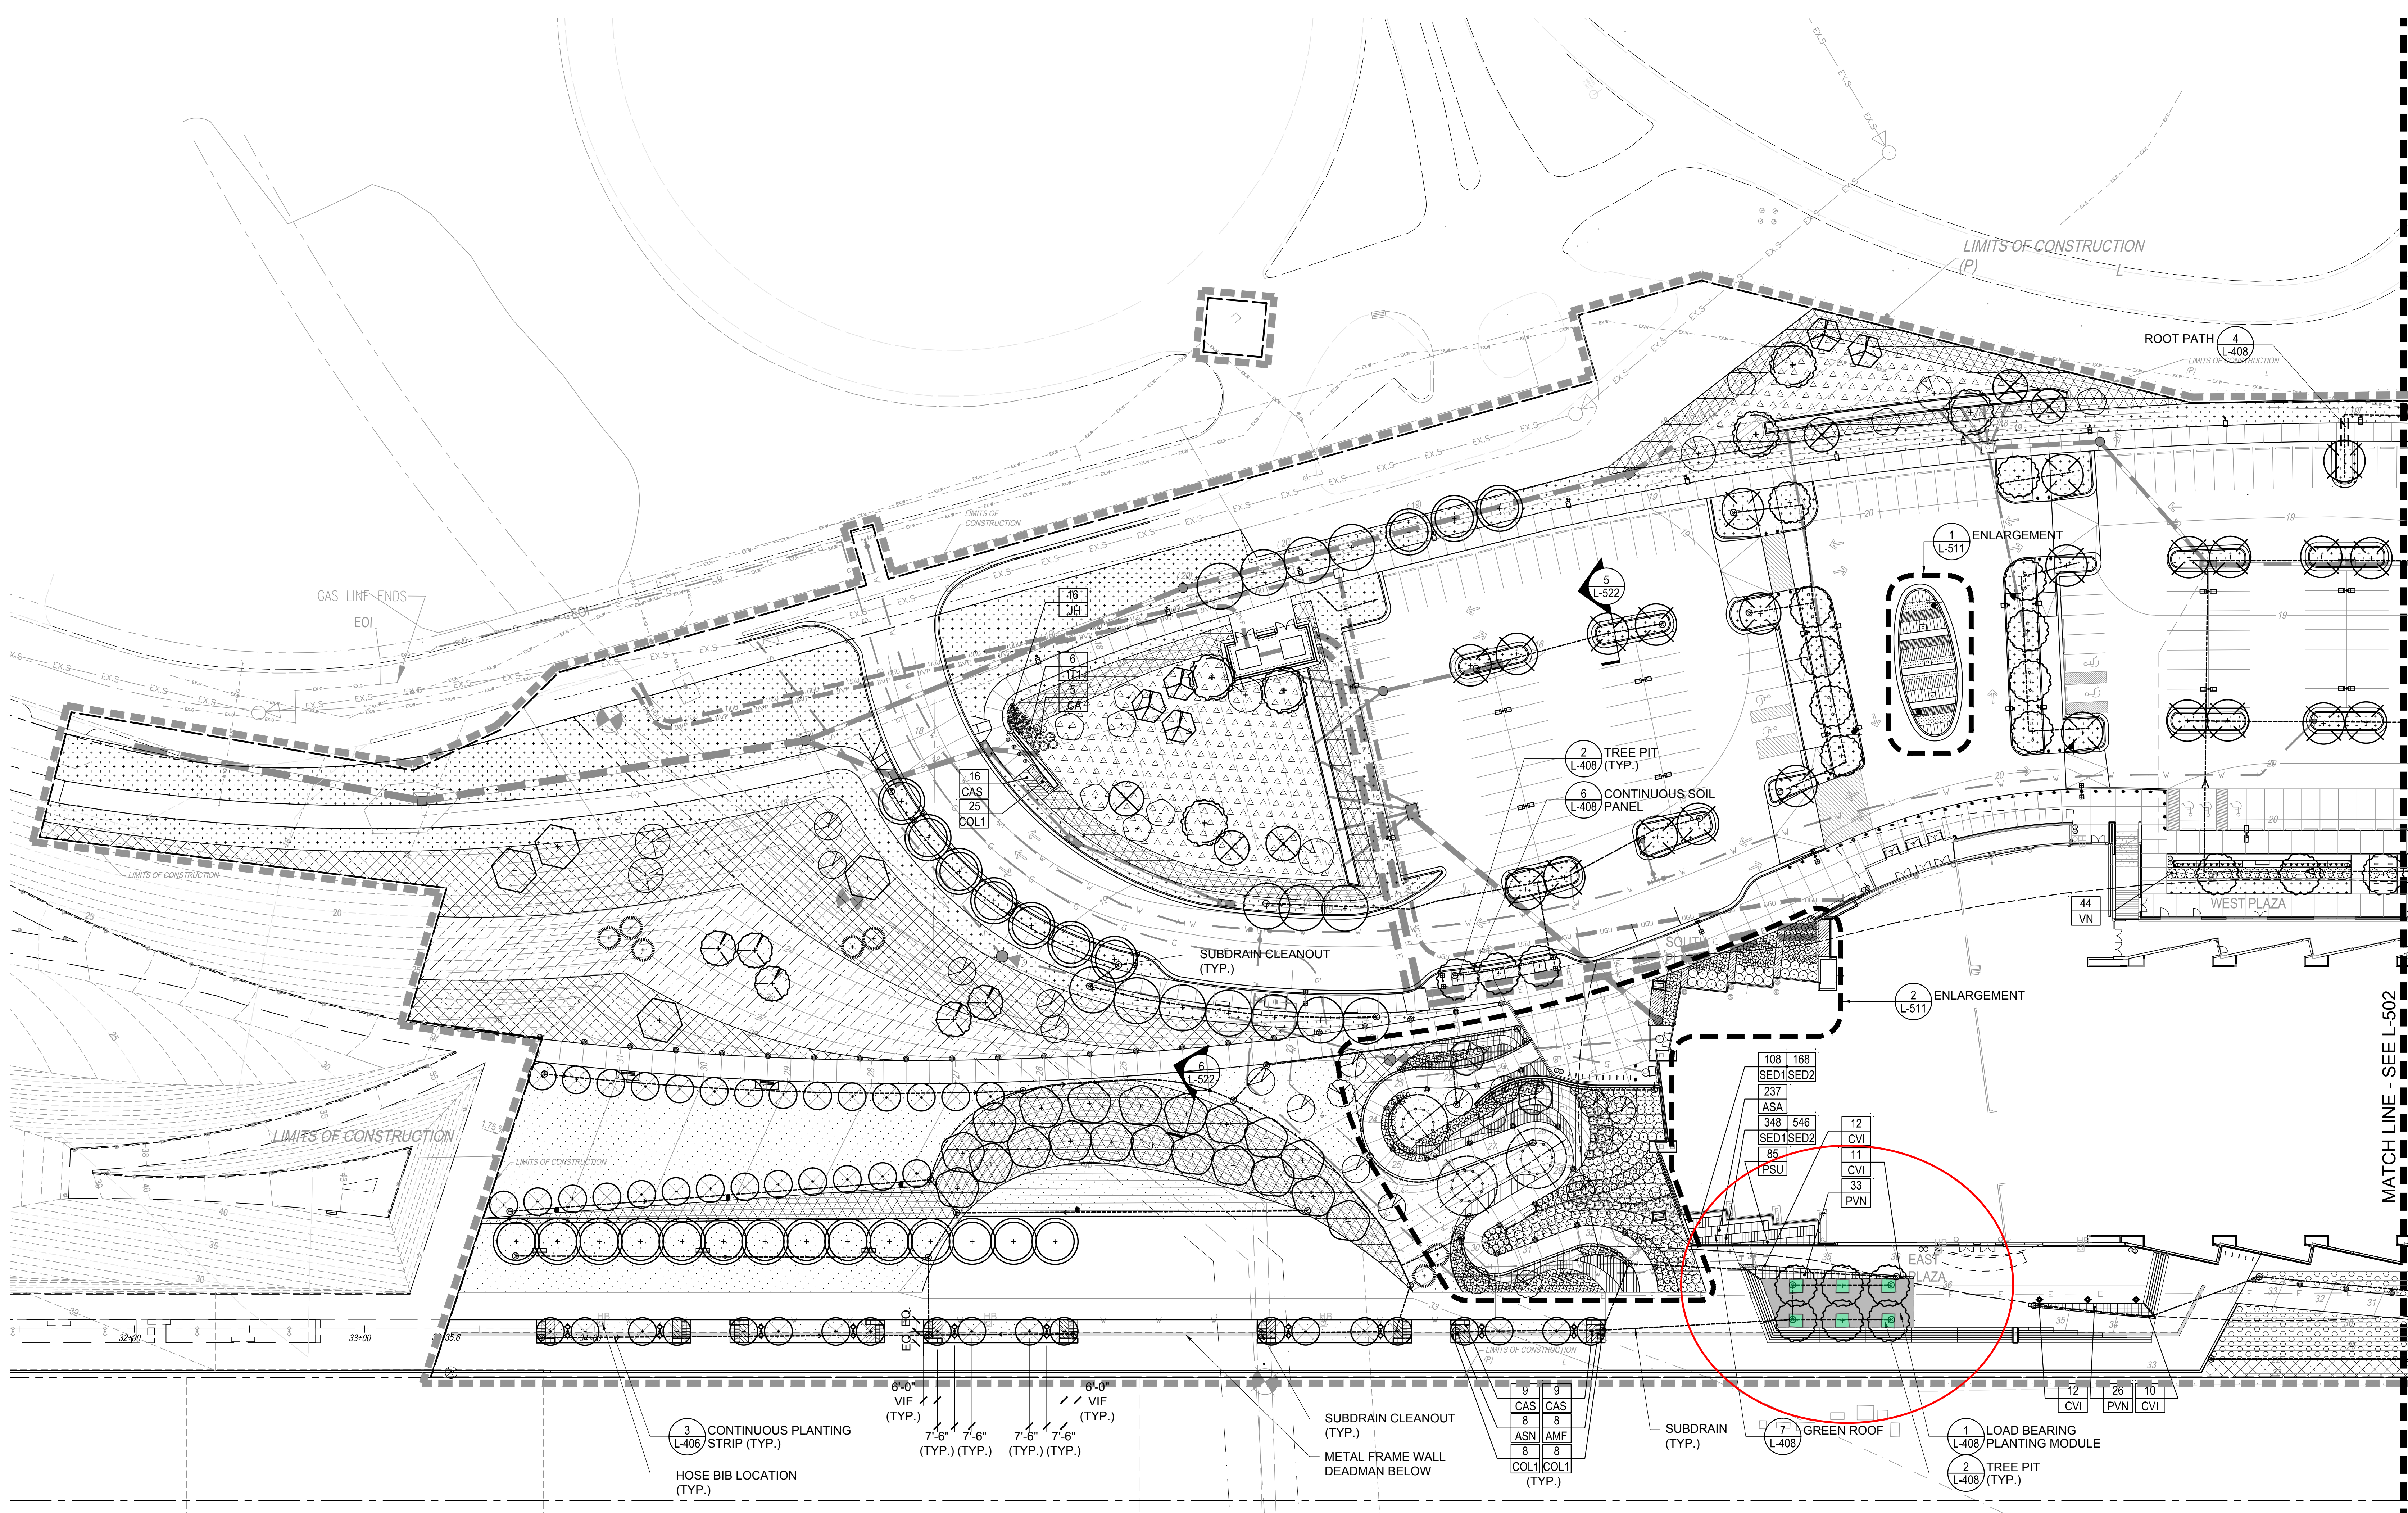

LEGEND

LOWER PLANTING MATERIALS

- LAWN A
- LAWN B
- MEADOW SEED MIX A
- MEADOW SEED MIX B
- MEADOW SEED MIX C
- SLOPE SEED MIX
- RAIN GARDEN SEED MIX
- PERENNIALS

NOTES:
1. SEE SHEET L-521 FOR PLANT SCHEDULE AND SEED MIX FORMULA.

