

IFB # 23-11

Project Name and Location

13th & Herndon Park Improvements

Materials Plan

Approvals Date

Dinesh Tisari 1/25/12  
Department Director  
A. Deleh 1/25/12  
Park Development Division Chief  
Design Unit Supervisor

Revisions Date

PER ZONING REVIEW 9/14/11  
PER DES REVIEW 10/12/11  
PER PRCR REVIEW 12/22/11

Designed: AW  
Drawn: AW  
Checked: BG



Filename: Materials\_R.dwg  
Plotted: Jan 23, 2012

Scale: AS SHOWN  
Date: 24 MARCH, 2011

Seal

Sheet 6 of 33

L-5.0

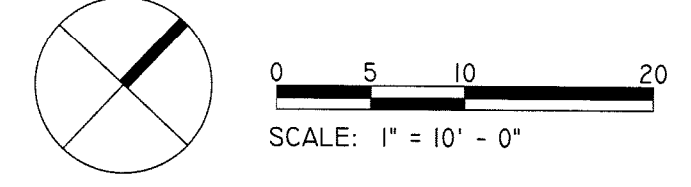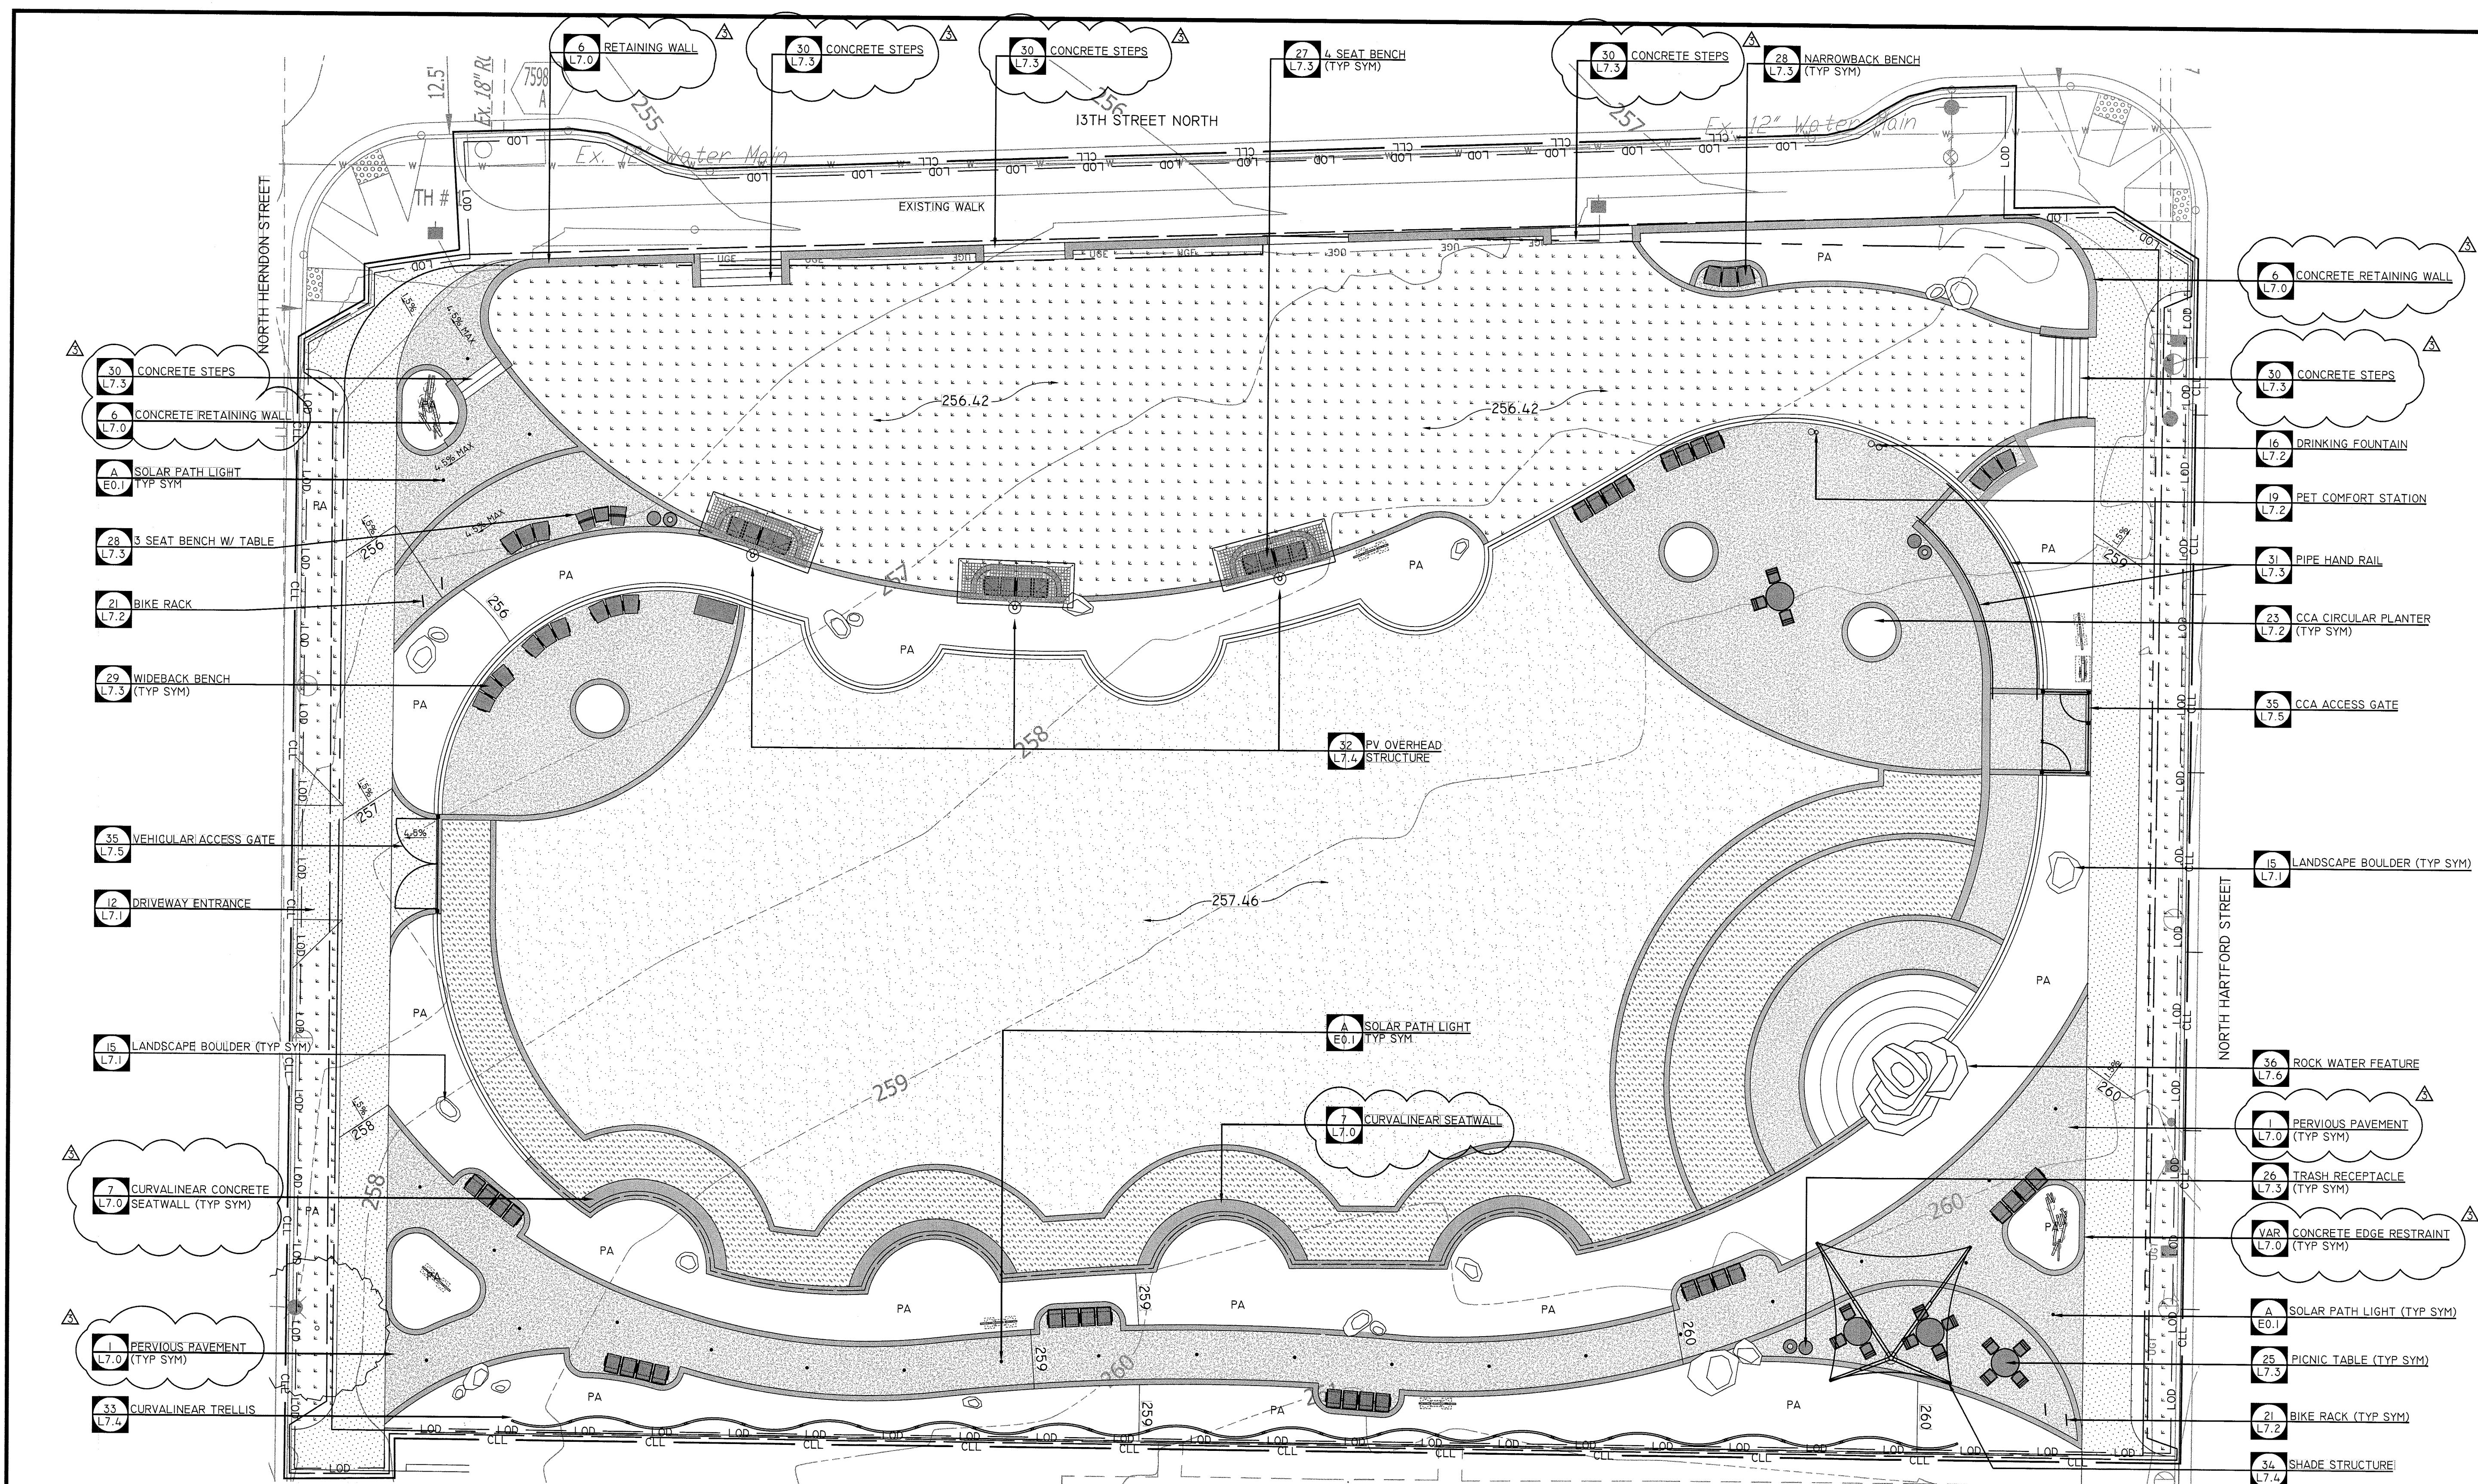

CONSTRUCTION ABBREVIATIONS (AS APPLICABLE)

ALIGN	ALIGNMENT
CONC	CONCRETE
PA	PLANTING AREA
SYM	SYMBOL
TYP	TYPICAL
VAR	VARIOUS

MATERIALS LEGEND

- DETAIL # SHEET #
- 18" SEATWALL
- SYNTHETIC TURF SURFACING - REFER TO SPECIFICATIONS

MATERIALS LEGEND (CONTINUED)

- CONCRETE PAVEMENT - REFER TO SPECIFICATIONS
- PERVIOUS PAVEMENT - REFER TO SPECIFICATIONS
- CRUSHER FINES / WASHED STONE DUST SURFACING
- TURFGRASS - REFER TO SPECIFICATIONS
- 8" LANDSCAPEFORMS 4-SEAT PLEXUS BENCH - REFER TO SPECIFICATIONS
- LANDSCAPEFORMS 3-SEAT PLEXUS BENCH - REFER TO SPECIFICATIONS

MATERIALS LEGEND (CONTINUED)

- ADA PICNIC TABLE (TYP SYM) - REFER TO SPECIFICATIONS
- TRASH RECEPTACLE (TYP SYM) - REFER TO SPECIFICATIONS
- 6" COMBO PARAGLAS / RETAINING WALL - REFER TO SPECIFICATIONS
- 6" COMBO FENCE / RETAINING WALL - REFER TO SPECIFICATIONS
- CONCRETE EDGE RESTRAINT - REFER TO PLANS AND SPECIFICATIONS
- CONCRETE FOOTING (TYP SYSTEM OVERHEAD STRUCTURES AND SHADE STRUCTURES) - REFER TO SUPPORT FOUNDATION SECTION DETAIL, SHEET S-1.1